



<small>THIS DRAWING WAS PRODUCED USING COMPUTER AIDED DESIGN SOFTWARE. THE ORIGINAL ELECTRONIC FILE IS MAINTAINED IN THE BOSTON OFFICE OF FOSTER WHEELER ENVIRONMENTAL CORPORATION. REPRODUCTION IN ANY FORM WITHOUT SPECIFIC WRITTEN PERMISSION IS PROHIBITED. DO NOT REMOVE THIS DRAWING MANUALLY.</small>	
PROJECT NO:	REVISIONS
CADD FILE NO:	DATE
OMNI_101.DWG	
DRAWING No	SYMBOL
C-1	
SHEET 1 OF 2	
P. E. SEALS APPROVED DATE: SEPTEMBER 2000 Scale: AS SHOWN Designed by: RMD Drawn by: CRP Checked by: RMD Approved by:	
Consulting FOSTER WHEELER ENVIRONMENTAL CORPORATION 133 FEDERAL STREET BOSTON, MASSACHUSETTS 02110 TEL: (617) 457-8200 FAX: (617) 457-8689	
Remediation OMNI ENVIRONMENTAL CORPORATION 433 West Street Amherst, MA 01002 (413) 256-6304	
Engineering BERNARDSTON LANDFILL CLOSURE BERNARDSTON, MASSACHUSETTS LANDFILL PLAN	

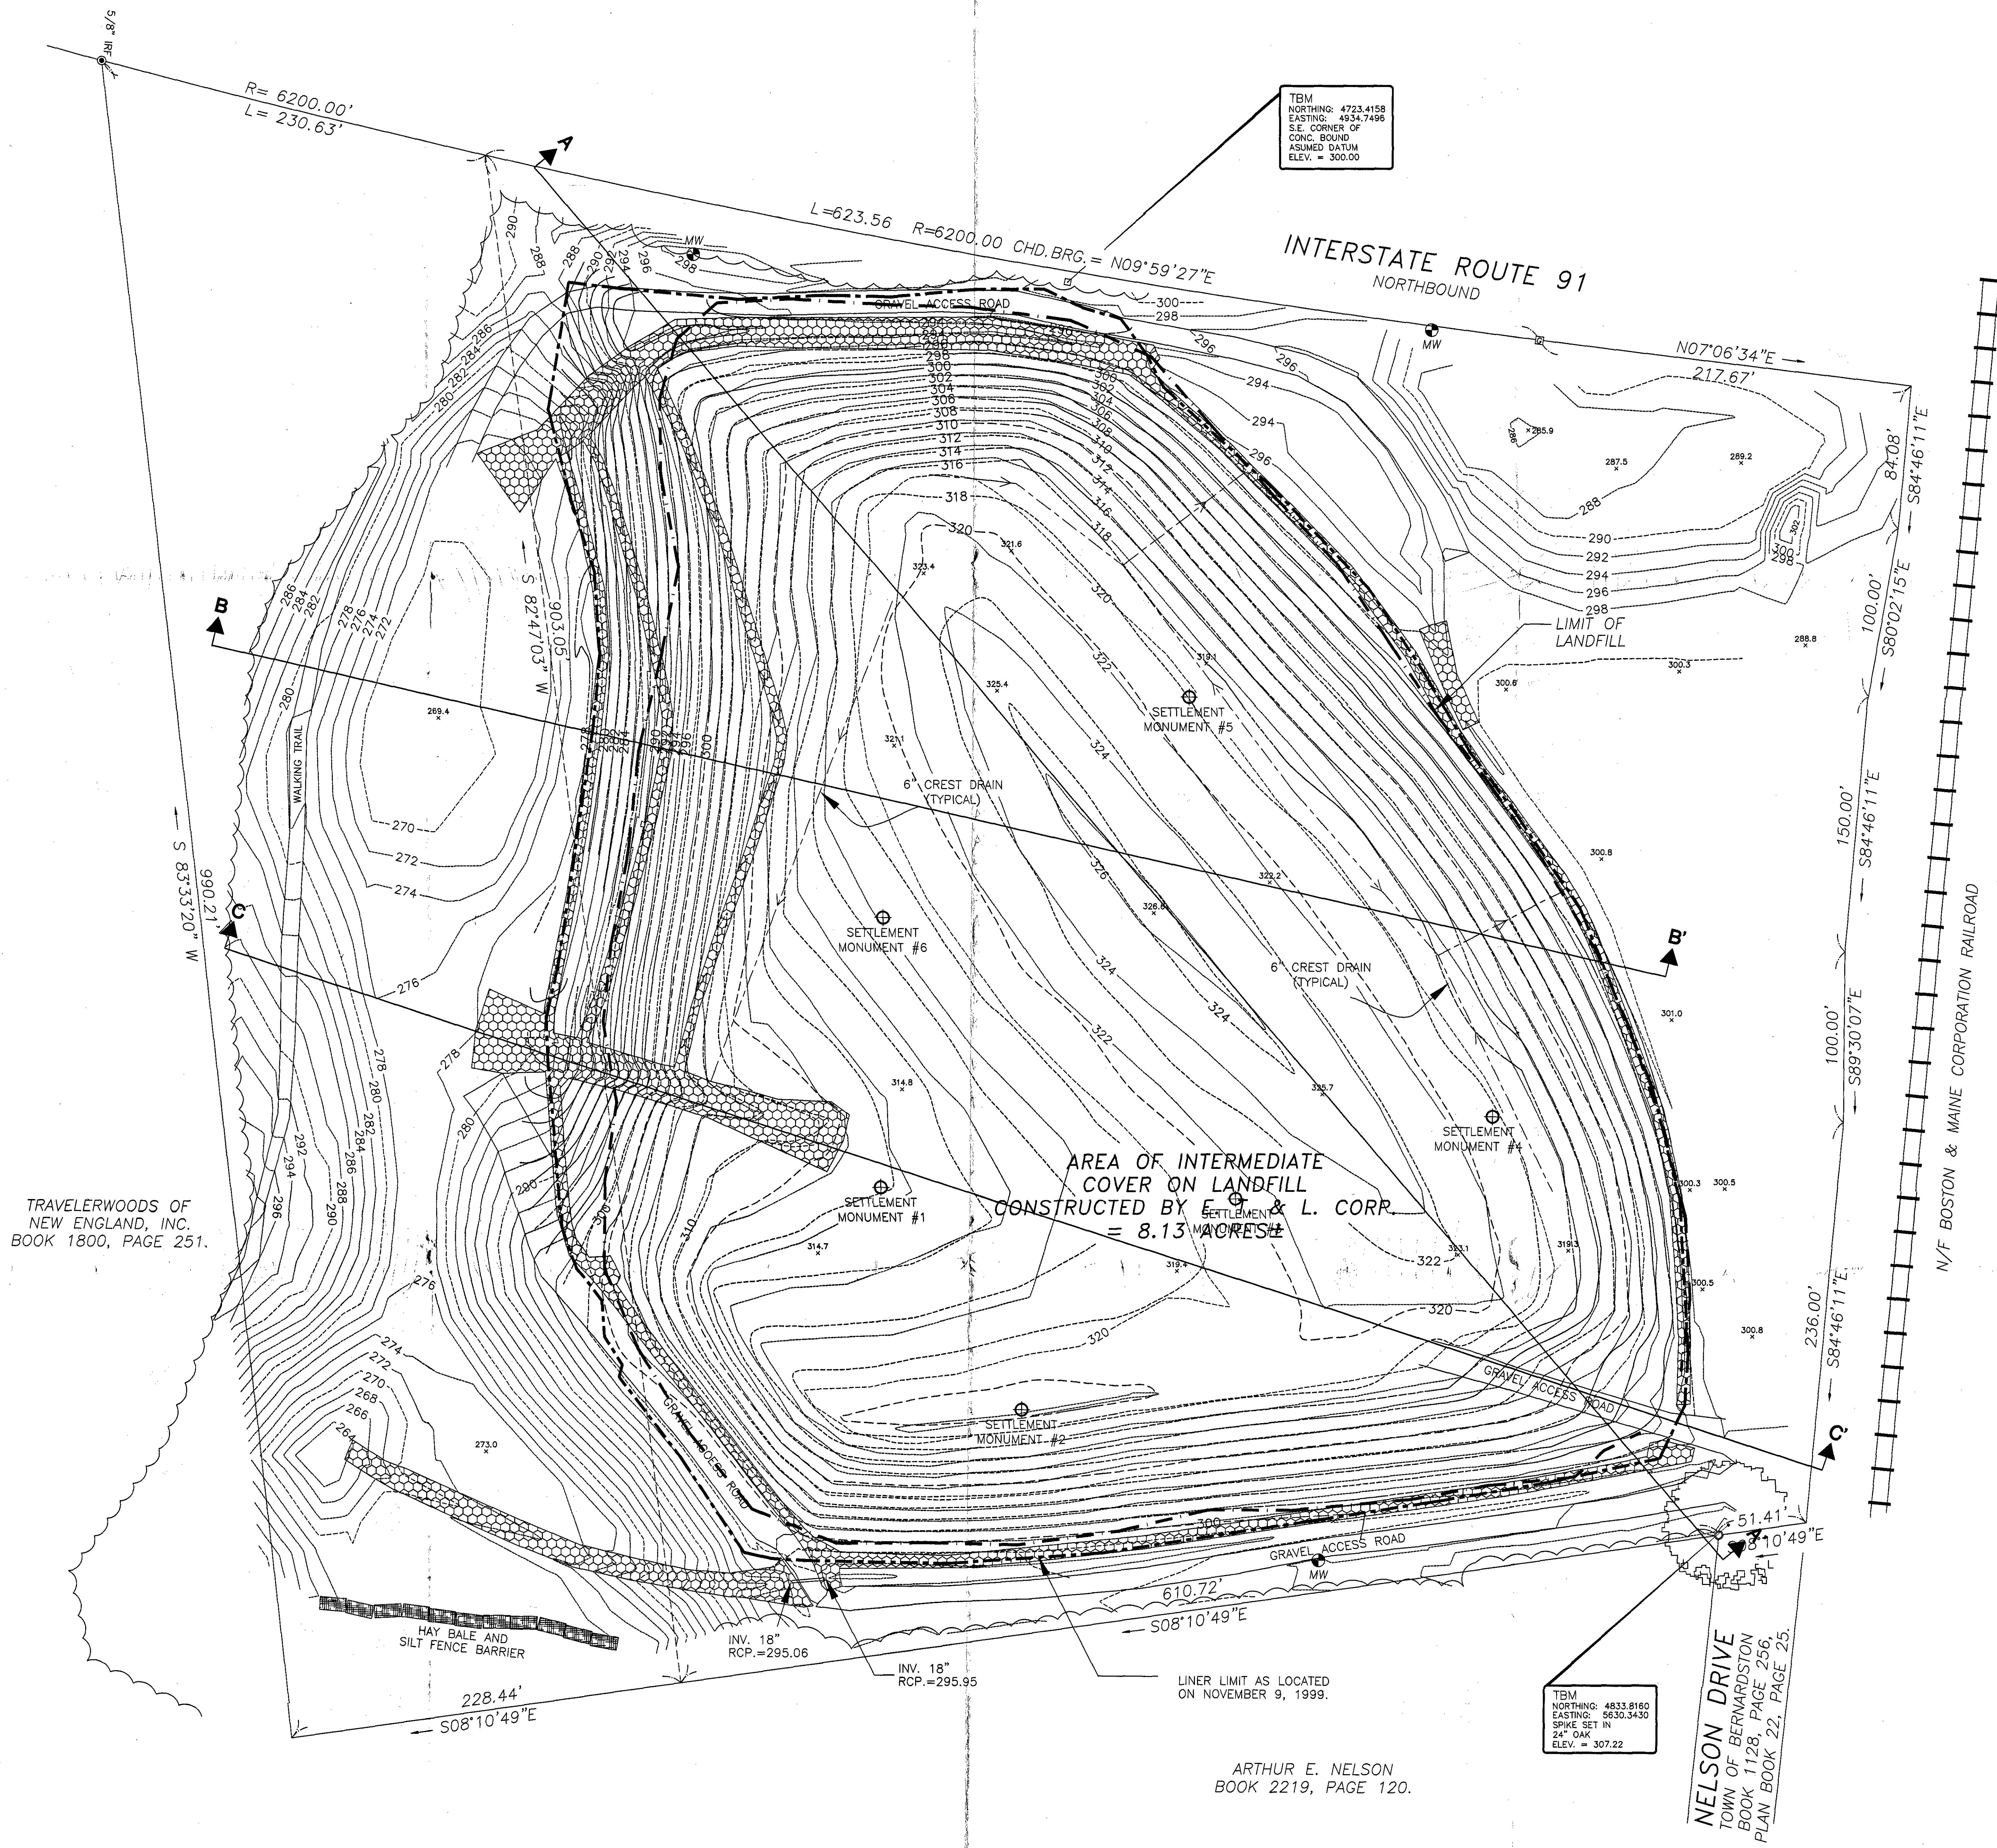

- LEGEND**
- FINAL GRADE 2' CONTOUR INTERVAL
 - FINAL GRADE 10' CONTOUR INTERVAL
 - INTERIM GRADE 2' CONTOUR INTERVAL
 - INTERIM GRADE 10' CONTOUR INTERVAL
 - IRON BAR FOUND
 - IRON PIPE FOUND
 - CONCRETE BOUND FOUND
 - GRANITE STONE BOUND FOUND
 - EDGE OF WOODS
 - MONITORING WELL
 - SETTLEMENT MONUMENT
 - SPOT GRADE
 - RIP-RAP AREA

NOTE
 PLAN INFORMATION SHOWN IS FROM AS-BUILT PLAN OF LAND, DATED FEBRUARY 11, 2000, AND INTERMEDIATE TOPOGRAPHICAL PLAN OF LAND DATED NOVEMBER 5, 1999, PREPARED BY HERITAGE SURVEYS, INC.

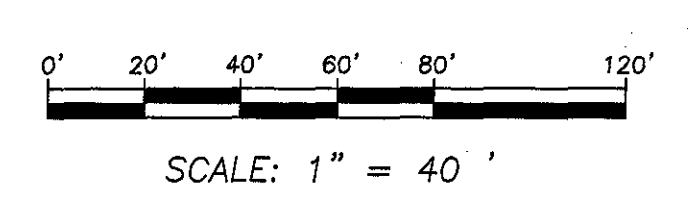

TBM
 NORTHING: 4723.4158
 EASTING: 4934.7498
 S.E. CORNER OF
 CONIC BOUND
 ASSUMED DATUM
 ELEV. = 300.00


TBM
 NORTHING: 4833.8160
 EASTING: 5630.3450
 SPIKE SET IN
 24" OAK
 ELEV. = 307.22

LINER LIMIT AS LOCATED
 ON NOVEMBER 9, 1999.


ARTHUR E. NELSON
 BOOK 2219, PAGE 120.

NELSON DRIVE
 TOWN OF BERNARDSTON
 BOOK 1128, PAGE 256,
 PLAN BOOK 22, PAGE 25.


TRAVELERWOODS OF
 NEW ENGLAND, INC.
 BOOK 1800, PAGE 251.

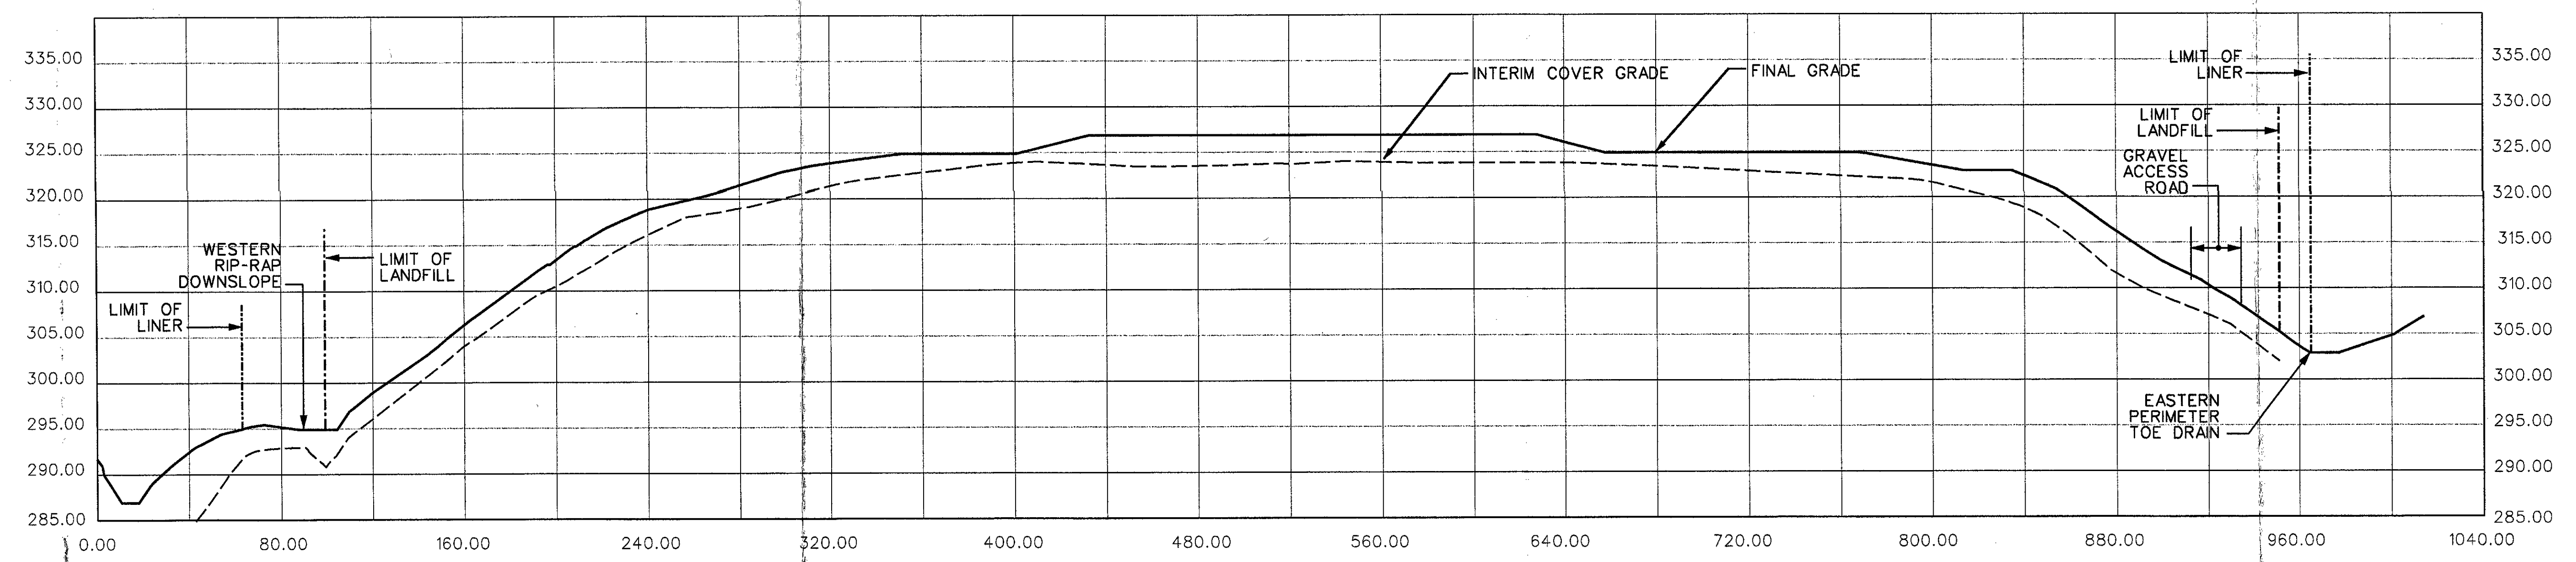

SECTION A-A'
SCALE: 1"=40' HORZ.
1"=10' VERT.

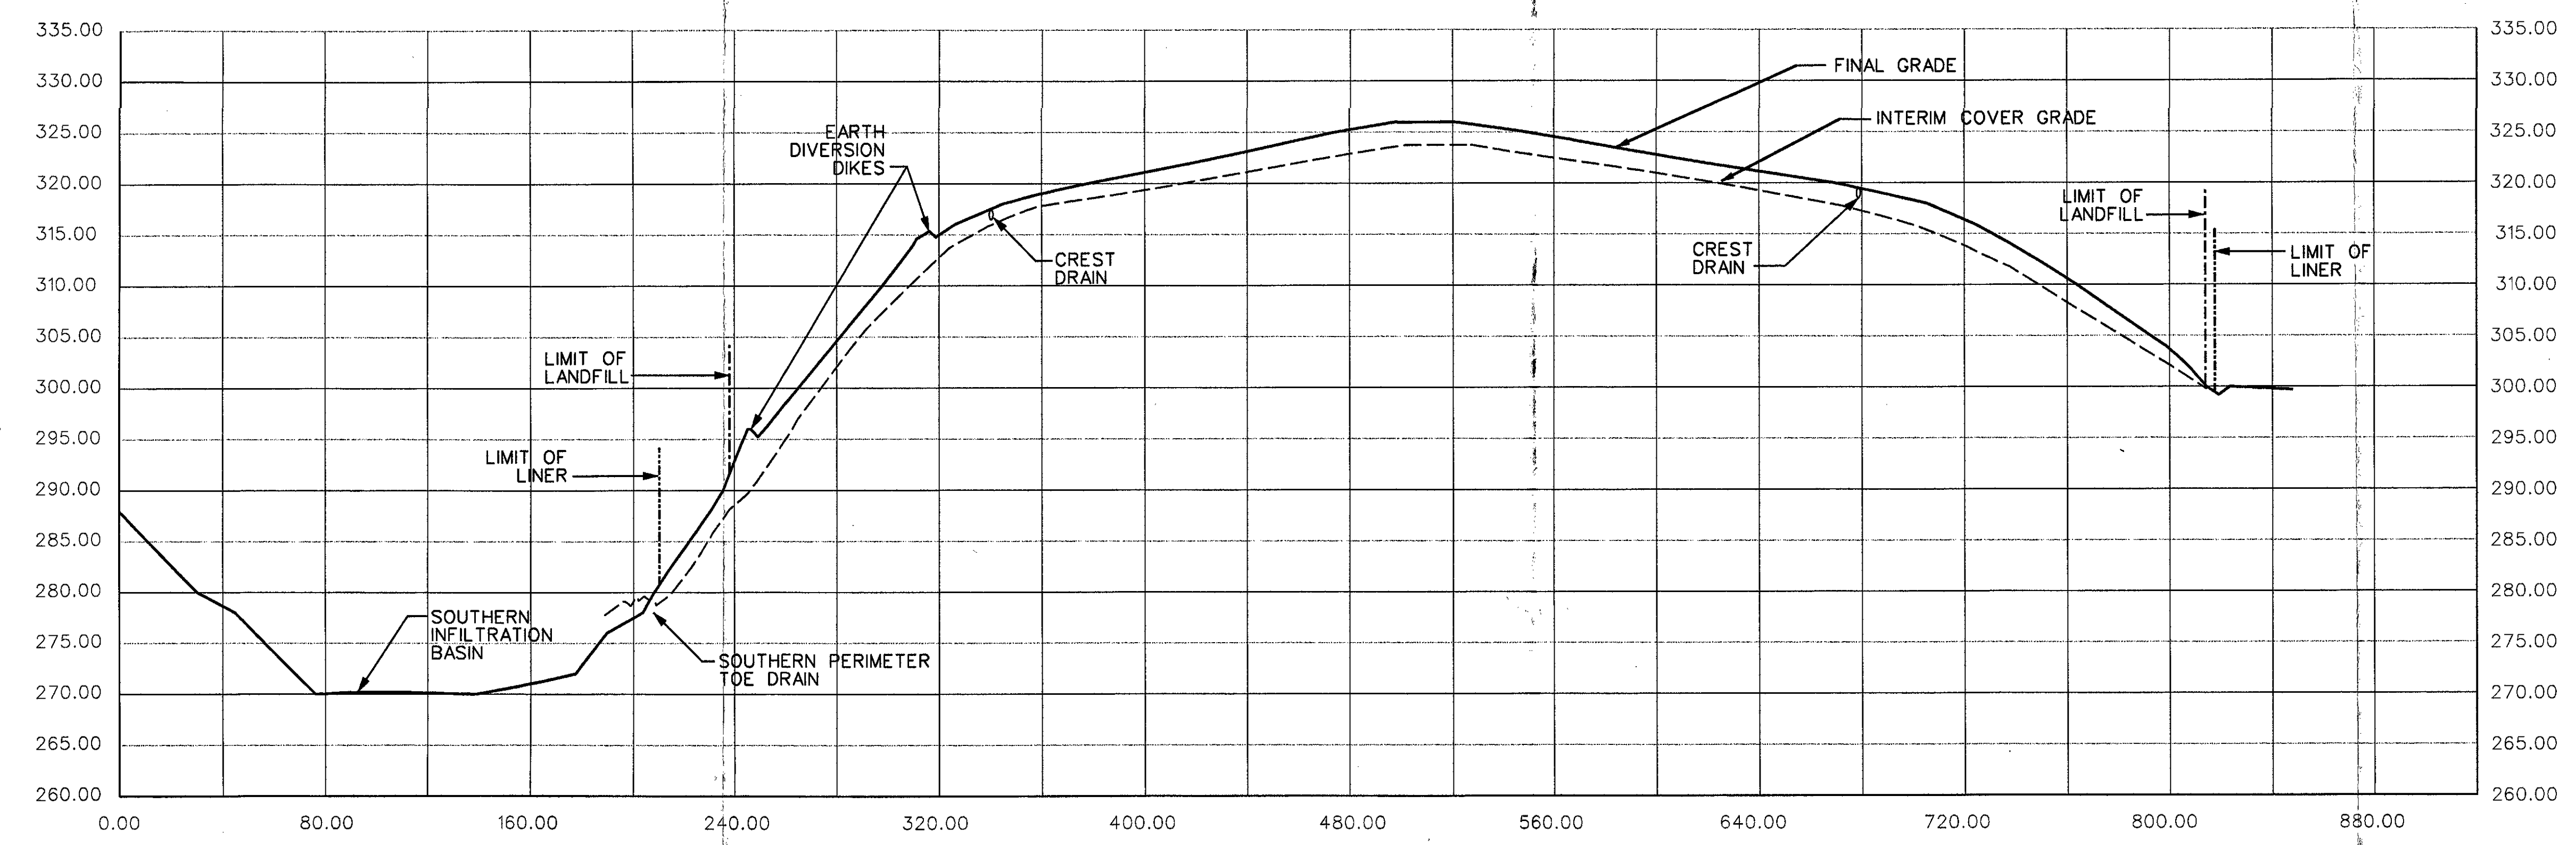


SECTION B-B'
SCALE: 1"=40' HORZ.
1"=10' VERT.

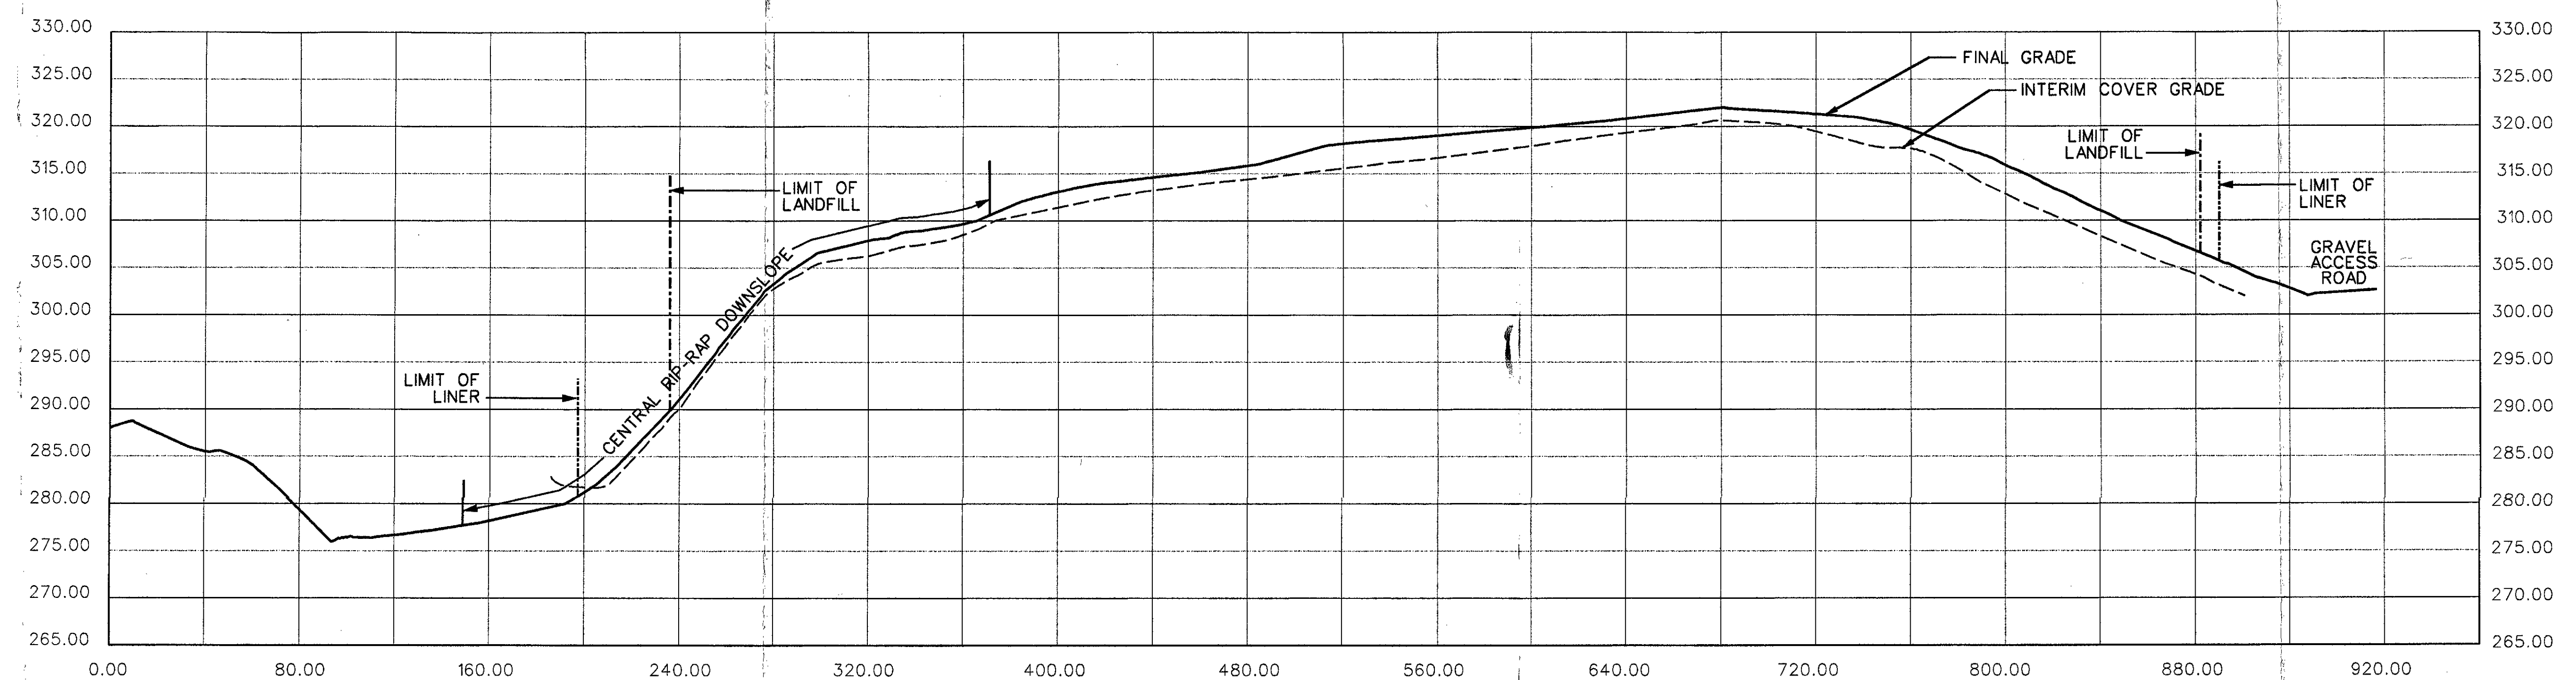

SECTION C-C'
SCALE: 1"=40' HORZ.
1"=10' VERT.

LEGEND
 ————— FINAL GRADE COVER
 - - - - - INTERIM GRADE

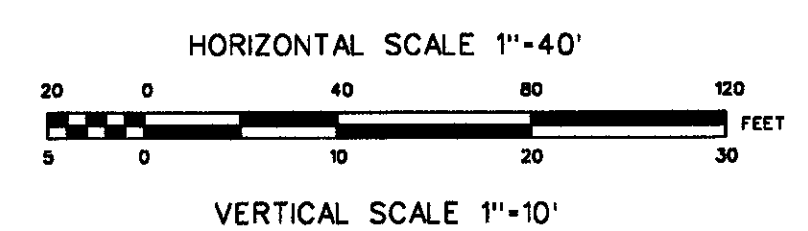

SYMBOL	DESCRIPTION	DATE	APPROVED

Date:	SEPT 2000
Scale:	AS SHOWN
Designed by:	ROM
Drawn by:	CRP
Checked by:	RMD
Approved by:	

Engineering Remediation Planning Consulting
FOSTER WHEELER ENVIRONMENTAL CORPORATION
 470 ATLANTIC AVENUE
 BOSTON, MASSACHUSETTS 02210-2208
 TEL: (617) 457-8200 FAX: (617) 457-8888/8889

OMNI ENVIRONMENTAL CORPORATION
 463 West Street, Amherst, MA 01002
 (413) 252-0284

BERNARDSTON LANDFILL CLOSURE
 BERNARDSTON, MASSACHUSETTS
LANDFILL CROSS SECTIONS

PROJECT NO:
 CAD FILE NO: OMNI_100.DGN
 DRAWING No
C-2
 SHEET 2 OF 2